

Douglas A. Ducey  
Governor



Andy Tobin  
Director

**ARIZONA DEPARTMENT OF ADMINISTRATION**

OFFICE OF THE DIRECTOR  
100 NORTH FIFTEENTH AVENUE · SUITE 401  
PHOENIX, ARIZONA 85007  
(602) 542-1500

June 10, 2020

Tim Moore, Chairman  
Arizona Silent Service Memorial Foundation  
18741 N. 92nd Drive  
Peoria AZ 85382  
[seawolfssn@outlook.com](mailto:seawolfssn@outlook.com)

Dear Mr. Moore:


Laws 2014, Fifty-first Legislature, Second Regular Session, Chapter 227 (SB1401) authorizes the Department of Administration (ADOA) to provide for the placement of a memorial dedicated to the commemoration of United States submarine veterans in Wesley Bolin Plaza.

Per the provisions of A.R.S. § 41-1363, ADOA has recognized the Arizona Silent Service Memorial Foundation as the proponent of the memorial.

As of this date: the Legislative Governmental Mall Commission approved the memorial on March 4, 2016; the ADOA General Services Division (GSD) has reviewed the concept and determined the most appropriate location for the memorial; the Arizona Historical Advisory Committee has made recommendations regarding the historical integrity of the memorial; GSD has approved the conditions of the design, dimensions and location of the memorial; and, the final construction plans have been reviewed for compliance with applicable code requirements.

Based on the abovementioned progress, I approve the design and location of the memorial; furthermore I direct GSD to prepare a contract with the Arizona Silent Service Memorial Foundation per the requirements of A.R.S. § 41-1363. Upon execution of the contract, ADOA will be able issue a Notice to Proceed for construction of the memorial.

Sincerely,

  
[Andrew Tobin \(Jun 10, 2020 12:21 PDT\)](#)

Andy Tobin  
Director

Attachment

cc: Nola Barnes, Assistant Director, ADOA GSD  
John Hauptman, General Manager, ADOA GSD


# CONSTRUCTION PLANS FOR ARIZONA'S SILENT SERVICE MEMORIAL

WESLEY BOLIN PLAZA  
1600 Washington Street  
Phoenix, Arizona



These plans and documents have been reviewed for compliance with the applicable code requirements of the jurisdiction. The stamping of these plans shall not be held to permit or be an approval of any violation of applicable codes and standards nor relieve the owner, design professional of record or contractor of compliance with applicable codes and standards. Plan review of documents does not authorize construction to proceed in violation of any federal, state, nor local regulation.  
**BUREAU VERITAS NORTH AMERICA, INC.**

Jason Field

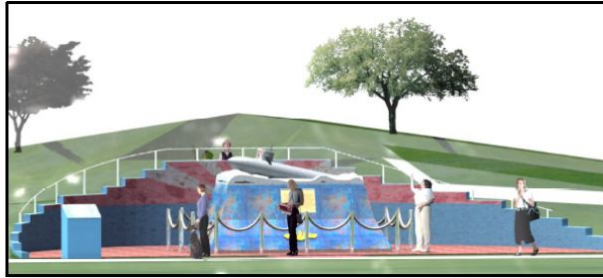

### INDEX OF SHEETS

- 1 COVER SHEET
- 2 SURVEY CONTROL AND SPECIFICATIONS
- 3 AERIAL OVERVIEW
- 4 SITE PLAN
- 5 WALL AND PAVER DETAILS
- 6 WALL FACING DETAILS
- 7 BASE DIMENSION DETAILS
- 8 COPPER PANEL AND PLAQUE DETAILS
- 9 PLAQUES AND DEDICATION PODIUM
- 10 SUBMARINE SCULPTURE DETAILS
- 11 MASONRY RETAINING WALL STRUCTURAL DETAILS
- 12 STRUCTURAL DETAILS
- 13 MISCELLANEOUS DETAILS
- 14 MISCELLANEOUS DETAILS

**REISSUED FOR REVISION 1  
CLARIFIED RETAINING WALL  
DETAILS AFFECTING SHEETS  
5 AND 11. 5-21-2020**



Location Map

**Bureau Veritas  
Reviewed For Code  
Compliance**  
06/04/2020



Stadium  
JK NORTH PE, PLLC  
4021 N. 19th Ave. Suite  
1000 Phoenix, AZ 85016  
602.974.1100  
jmartin@jkpe.com



Owner

Authorized by Senate Bill 1401 signed April 24, 2014 Laws 2014, Fifty-first Legislature Second Regular Session, Chapter 227 and as amended by Laws 2016, Fifty-second Legislature Second Regular Session, Chapter 344

April 12, 2020

**APPLICABLE BUILDING CODES**  
2018 International Building Code

### CODE REQUIRED SPECIAL INSPECTIONS

- Concrete
- Bolts in Concrete
- Reinforcing and Pre-stressing Steel
- Structural Masonry


### AS-BUILT CERTIFICATION

I hereby certify that the "as-built" measurements as shown herein were made under my supervision or as noted and are correct to the best of my knowledge and belief.


Registered Land Surveyor \_\_\_\_\_ Date \_\_\_\_\_  
Registered Engineer \_\_\_\_\_

### General Notes:




All work shall be performed in accordance with the latest edition of the Uniform Standard Specifications for Public Works Construction and Uniform Standard Details for Public Works Construction as published by the Maricopa Association of Governments unless noted otherwise.

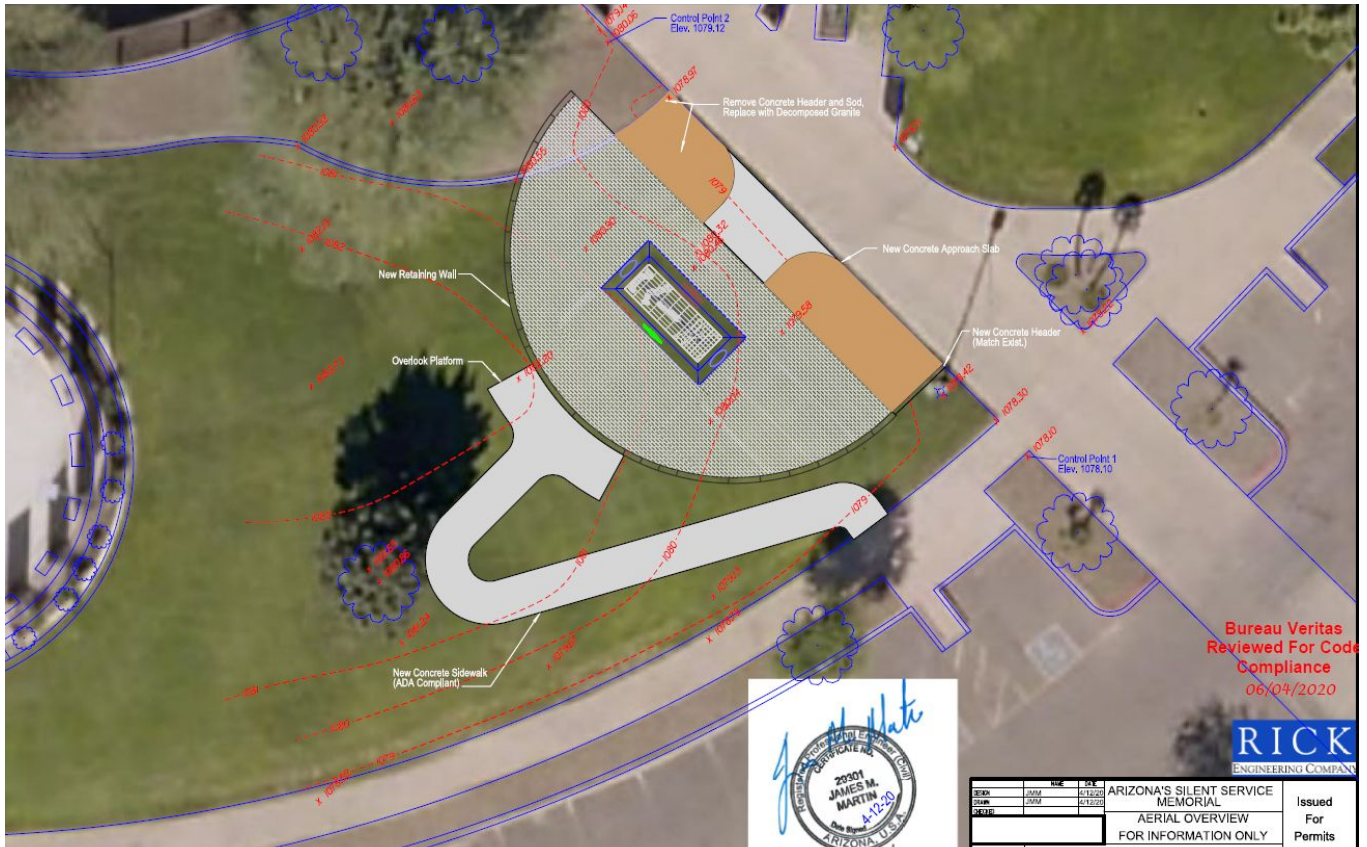

**Bureau Veritas  
Reviewed For Code  
Compliance**  
06/04/2020

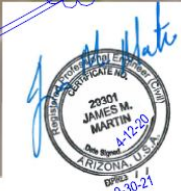

NO.	DATE	BY	DESCRIPTION	ISSUED FOR PERMITS
1	2020	JM	ARIZONA'S SILENT SERVICE MEMORIAL	Issued For Permits
2	2020	JM	AERIAL OVERVIEW	
3	2020	JM	FOR INFORMATION ONLY	
CIVIL PLANS				..3.. OF 14

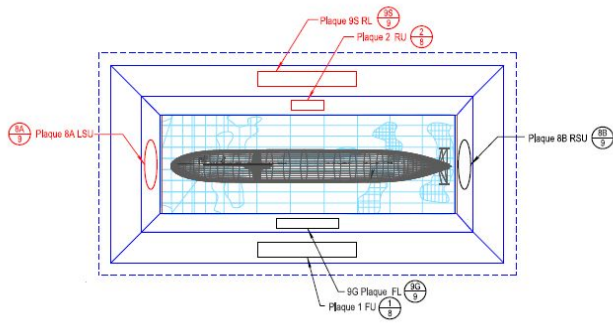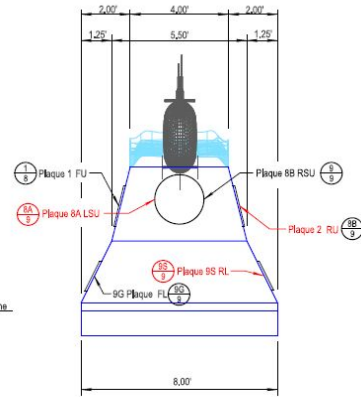
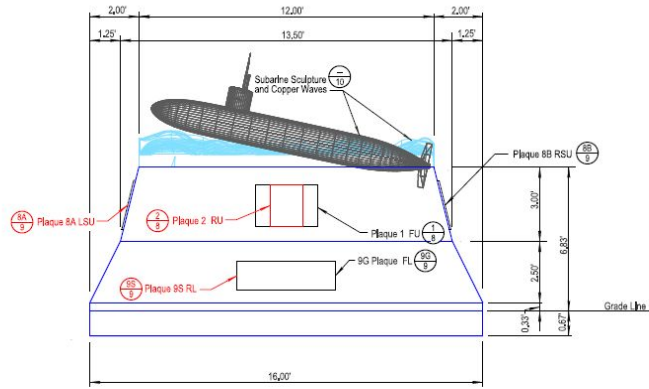


Bureau Veritas  
Reviewed For Code  
Compliance  
06/04/2020



This Sheet is for Base Dimensions Only.  
See Sheets 8, 9 and 13 for Additional Information and Details on Plaques.

DATE	BY	CHK	DESCRIPTION	ISSUED FOR PERMITS
06/04/2020	JMM	AM	ARIZONA'S SILENT SERVICE MEMORIAL	Issued For Permits
06/04/2020	JMM	AM	BASE DIMENSION DETAILS	
			CIVIL PLANS	7 OF 14

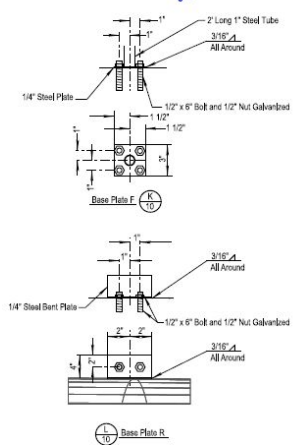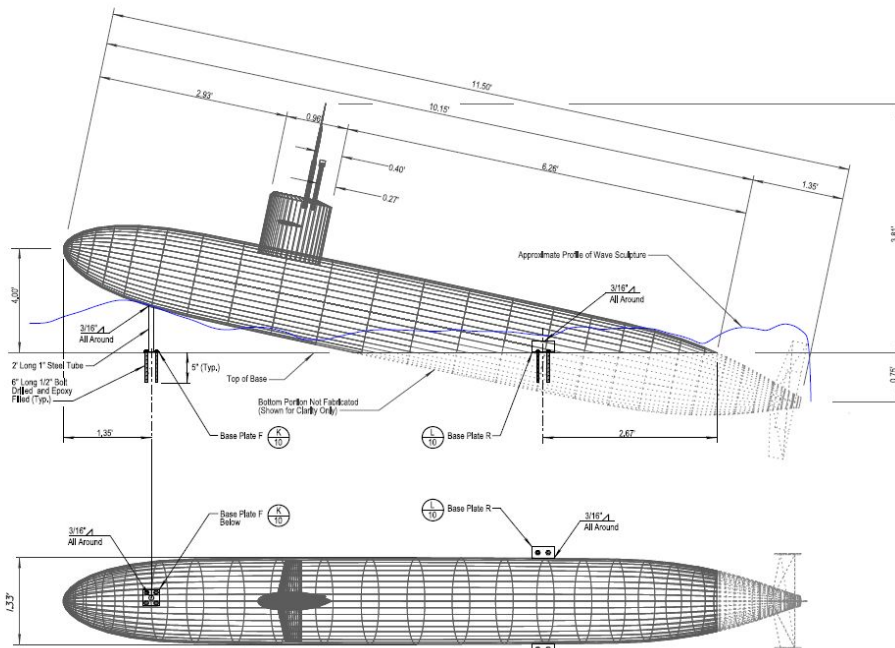

Bureau Veritas  
Reviewed For Code  
Compliance  
06/04/2020

DATE	BY	CHK	DESCRIPTION	ISSUED FOR PERMITS
06/04/2020	JMM	AM	ARIZONA'S SILENT SERVICE MEMORIAL	Issued For Permits
06/04/2020	JMM	AM	SUBMARINE SCULPTURE DETAILS	
			CIVIL PLANS	10 OF 14